


OFFICE OF THE MARION COUNTY SURVEYOR
SECTION RECORD CORNER
SECTION 11 TOWNSHIP 16 RANGE 3
DATE: --6-13-99-- 6-9-04
PARTY CHIEF: Wilcoxon
CREW: _____
TYPE OF MARKER: Harrison
METHOD OF ESTABLISHMENT: County: 3-14-93

IN. S.P.C. ZONE E, NAD 83
NAME: 16031101
N: 511418.5046(m)
E: 56191.4833(m)
changed 11/11/02

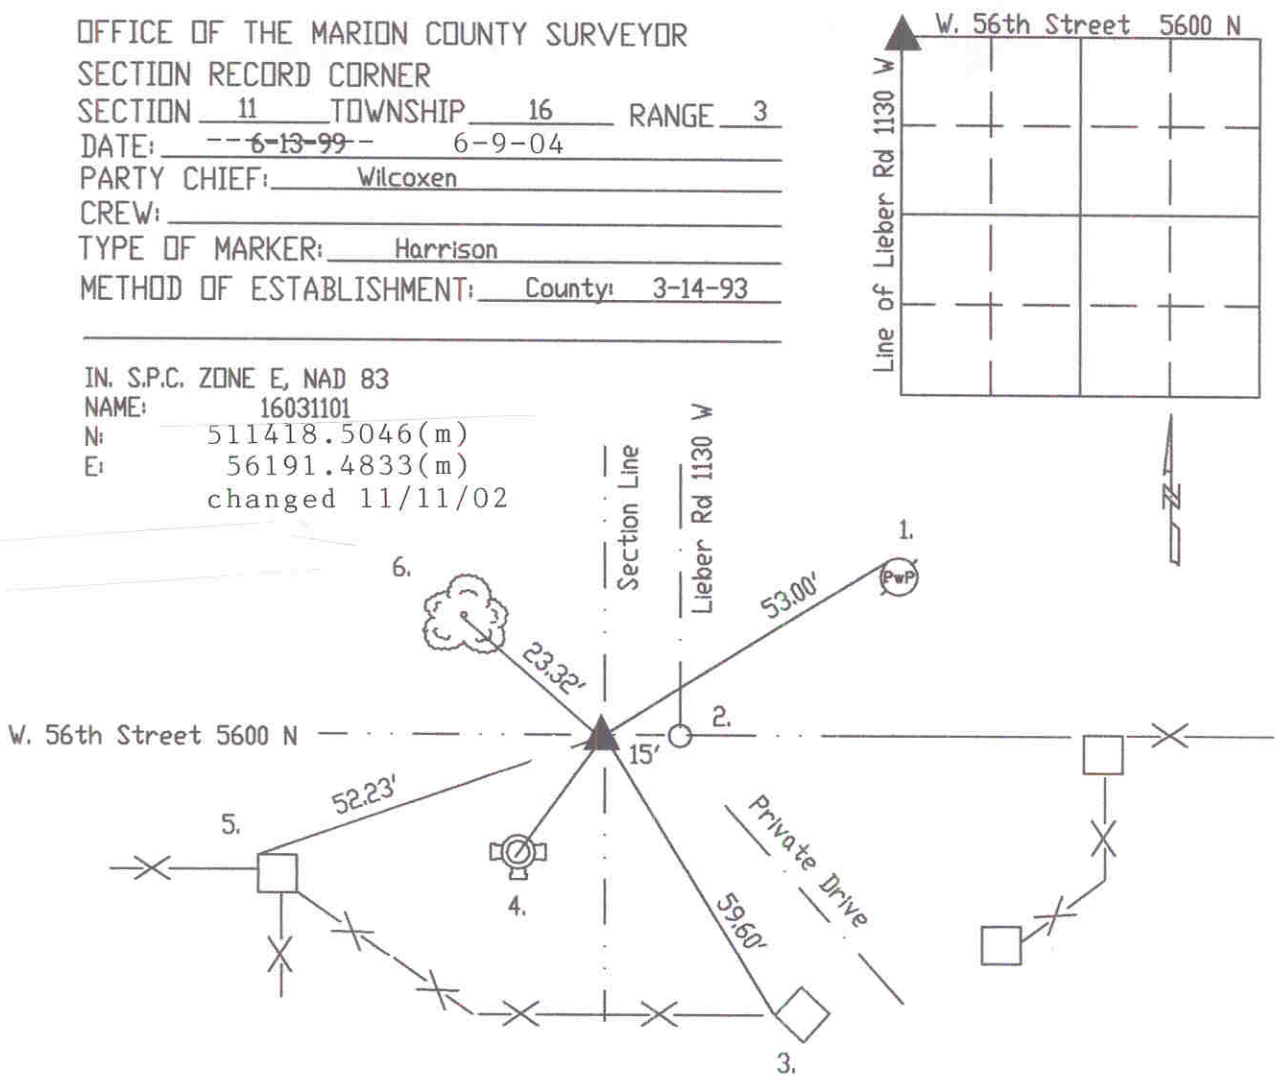

Original post set 1820 by Wm.B. Laughlin with witnesses: 12" hickory N 53 W 19 links, 10" beech S 55 E 37 links per Marion County Atlas pg. 7. Washington Township Legal Survey Book indicates no stone nor witnesses. 7-2-64 does not indicate type of marker. Miller 11-17-75 called a railroad spike. Greene 6-11-86 called the same. Wilcoxon 3-14-93 called the same. 6-26-98 the corner was put in question and under investigation. The old tie cards were in error so we used Highland Manor Sub PB 27, pg. 29 and Highland Kessler Estates 1st & 2nd Section. Also we used the W Q 2-16-3 and went S to a Q Q stone and extended line by coming from the N, W & E, we had a 1' area to dig for a stone. 6-12-99 Wilcoxon excavated the area and found a stone 16" down. 6-13-99 Harrison set in position of the stone by Wilcoxon.

HC631101

REF.	DISTANCE	DESCRIPTION
1.	53.00'	PK nail NW PwP#21-334A 3'up
2.	15.00'	Due E to C/L of Lieber Road
3.	59.60'	Westerly corner of brick column
4.	32.16'	Top nut of fire hydrant
5.	52.23'	NW corner brick column
6.	23.32'	Mag nail w/brass washer SW 40' pin oak spur root